


KETERANGAN:




TUBE KABEL _____

CORE KABEL _____

JAKET KABEL _____

ODP/FAT

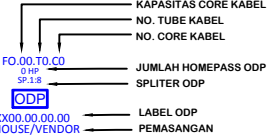

ALOKASI CORE:

KAPASITAS CORE KABEL

NO. TUBE KABEL

NO. CORE KABEL

JUMLAH HOMEPASS ODP

SPLITER ODP

LABEL ODP

PEMASANGAN

KAPASITAS KABEL, TUBE DAN CORE

A. 6 CORE / 1 TUBE, 1 TUBE = 6 CORE

B. 12 CORE / 2 TUBE, 1 TUBE = 6 CORE

C. 24 CORE / 4 TUBE, 1 TUBE = 6 CORE


D. 48 CORE / 4 TUBE, 1 TUBE = 12 CORE










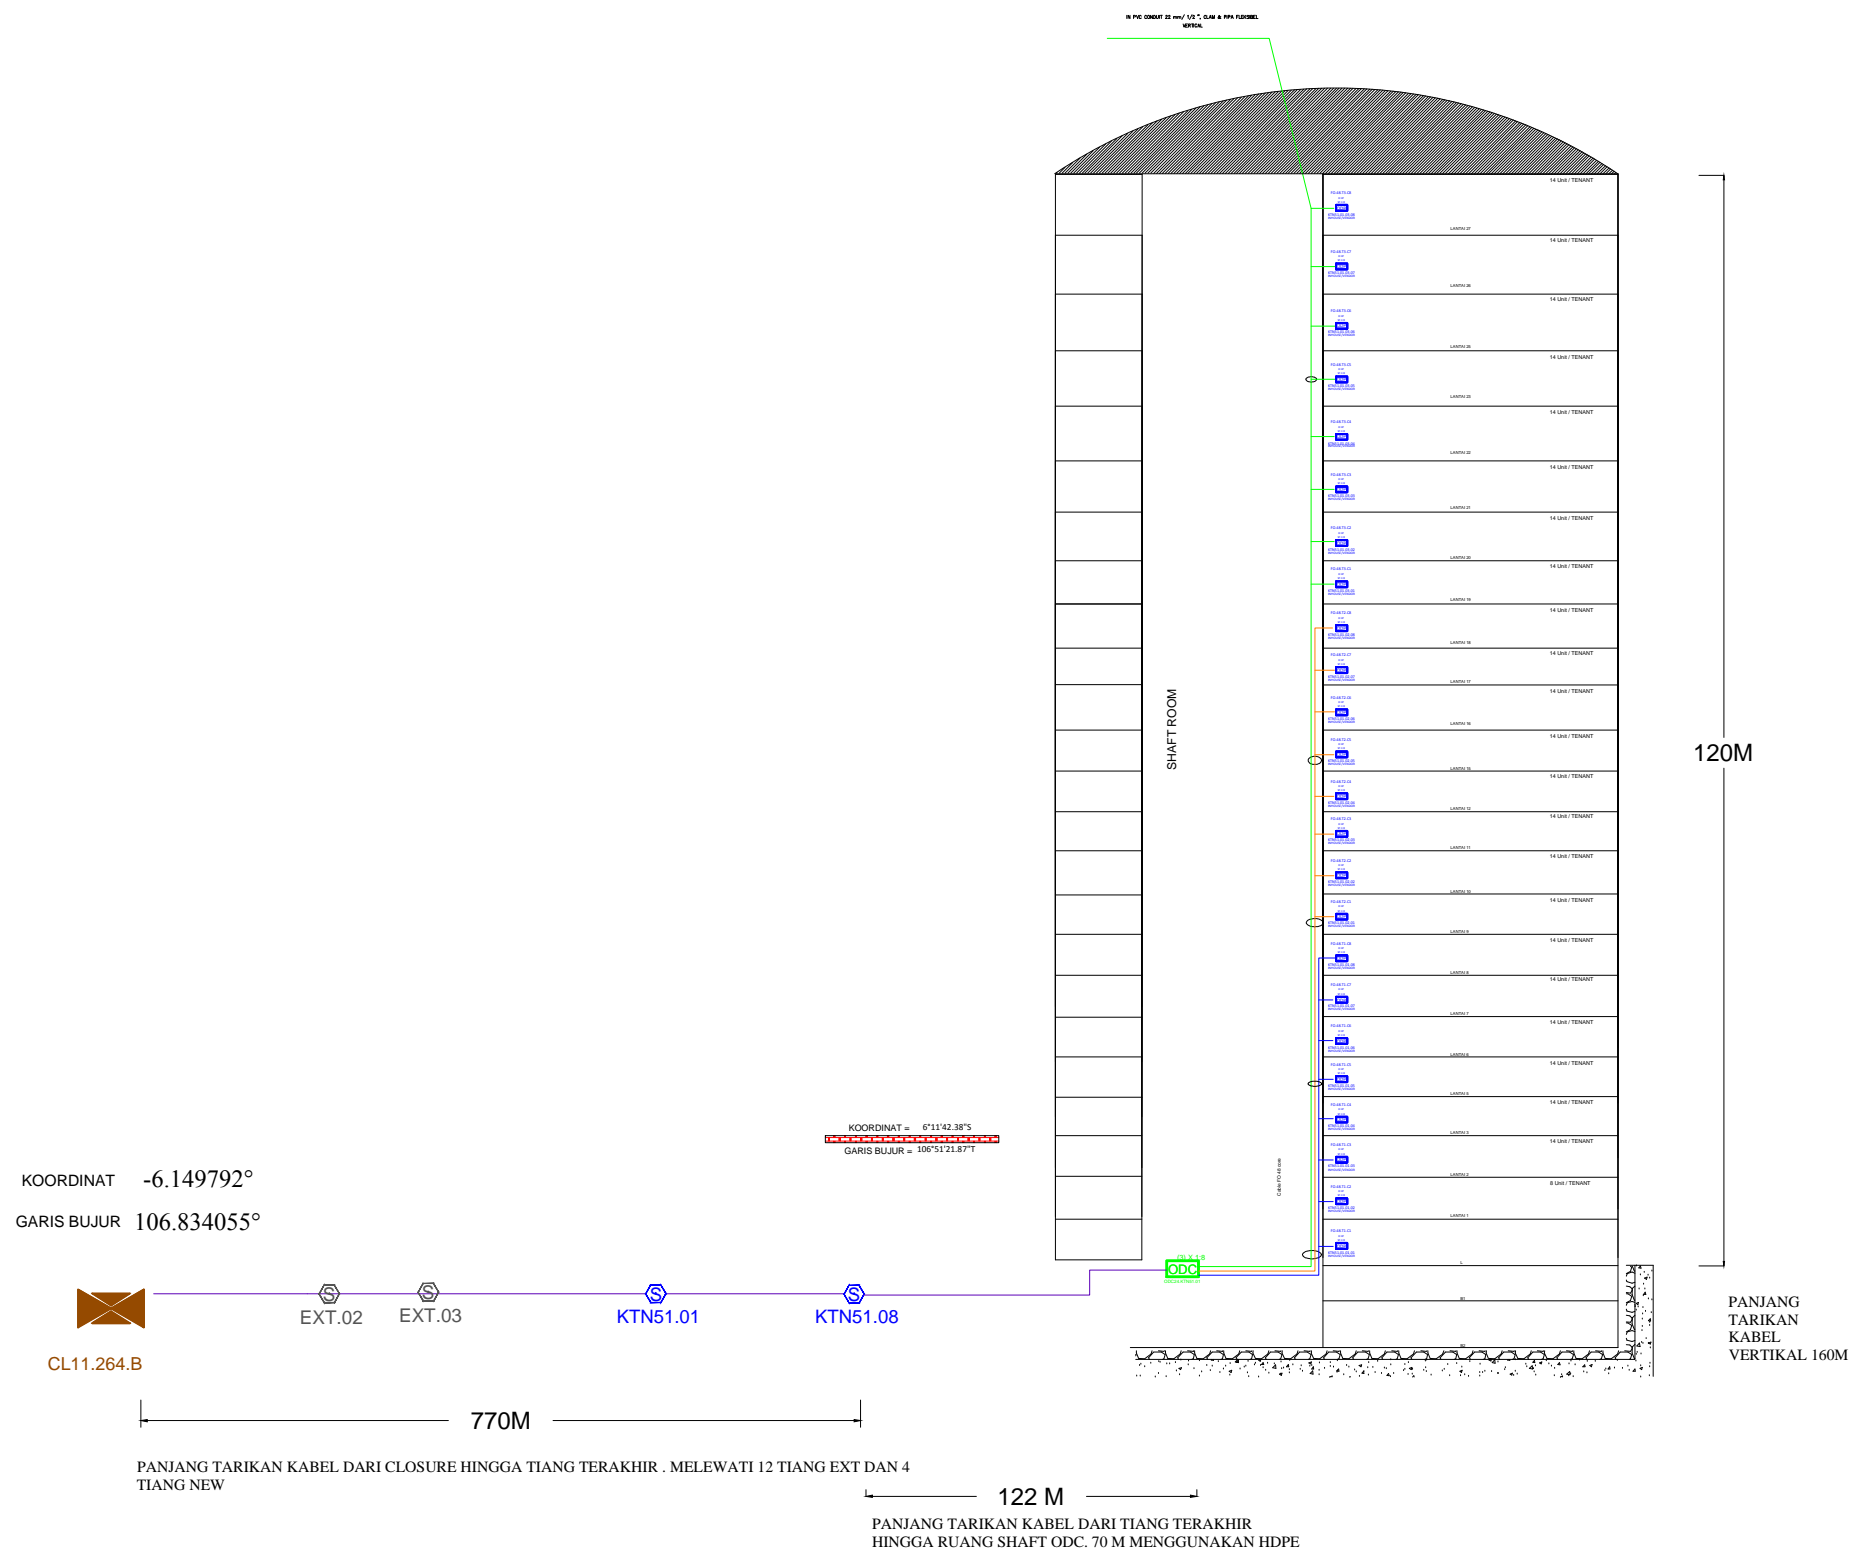



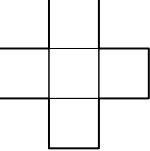








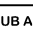
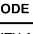
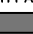




 



 
 



F. 96 CORE / 8 TUBE, 1 TUBE = 12 CORE

G. 144 CORE / 12 TUBE, 1 TUBE = 12 CORE

H. 264 CORE / 22 TUBE, 1 TUBE = 12 CORE

GRAND KARTINI



AS BUILT DRAWING OUTSIDE PLAN FIBER TO THE HOME					
PROJECT TYPE		:			
AS PLAN NUMBER		: 0000.A/APD/KOTA/FTTH/VENDOR/ROUTE PLAN/VIII/17			
AS BUILT NUMBER		: 0000.A/ABD/KOTA/FTTH/VENDOR/ROUTE PLAN/VIII/17			
DATE		: TANGGAL / BULAN / TAHUN			
MAP ID		:			
DATE MAP ID		: BULAN / TAHUN			
					
INHOUSE					
LEGEND				QUANTITY	
 - HUB OLT				- PON PORT	
 - FIXING SLACK				-	
 - JOIN CLOSURE				1 EXT	
 - ODC/FDT/FIBER DISTRIBUTION TERMINAL				PCS - 72 CORE 1 PCS - 24 CORE	
 - ODP/FAT/FIBER ACCESS TERMINAL				24 PCS 1:8 - PCS 1:8X2	
 - EXISTING MKM HANDHOLE				-	
 - HANDHOLE 150X150X150 CM				-	
 - HANDHOLE 120X120X120 CM				-	
 - HANDHOLE 100X100X100 CM				-	
 - HANDHOLE 80X80X80 CM				-	
 - HANDHOLE PIT 60X60X60 CM				-	
 - HANDHOLE PIT 40X40X40 CM				-	
 - CABLE RISER				-	
 - RILLING ASPHALT (BORING ASPAL)				-	
 - EXCAVATION ASPHALT (GALI ASPAL)				-	
 - EXCAVATION LAND (GALI TANAH)				-	
 - EXCAVATION GRASS (GALI RUMPUT)				-	
 - POLE 9 METER				-	
 - POLE 7 METER				8 PCS	
 - GALVANIZED PIPE 6 METER				-	
 - EXISTING MKM POLE				3 PCS	
 - ANOTHER POLE				-	
 - L-KONEKTOR				-	
 - T-KONEKTOR				-	
 - DUCT FO.				-	
 - DUCT DW.				-	
 - DROP WIRE				-	
 - FIBER 6/2T				-	
 - FIBER 12/2T				-	
 - FIBER 24/4T				-	
 - FIBER 48/4T				1052 METER	
 - FIBER 72/6T				-	
 - FIBER 96/8T				-	
 - FIBER 144/12T				-	
 - FIBER 264/22T				-	
HOMEPASS				192	
HUB AREA		: OLT			
NODE AREA		: KARTINI			
CITY AREA		: JAKARTA PUSAT			
ACKNOWLEDGE					
_____ KADIV ROLLROUT			_____ KADIV PPL		
REVIEW					
_____ Ka. Dept. ROLLROUT			_____ Ka. Dept. PPL		
DRAWING NAME					
ROUTE PLAN					
SCALE					
NTS					
PAGE					
1 OF 1					
PT. MNC KABEL MEDIACOM					
REVISION		INITIALS		DATE	
CHECKED BY		PIC PLAN REGION			
DRAWN BY					
				RM REGION	

STANDARD WARNA TUBE

VISUAL	WARNA	NO. TUBE	KAP. KABEL
	= BIRU	= TUBE 1	6 CORE
	= ORANGE	= TUBE 2	12 CORE
	= HIJAU	= TUBE 3	
	= COKLAT	= TUBE 4	24/48 CORE
	= ABU	= TUBE 5	
	= PUTIH	= TUBE 6	
	= MERAH	= TUBE 7	
	= HITAM	= TUBE 8	96 CORE
	= KUNING	= TUBE 9	
	= UNGU	= TUBE 10	
	= PINK	= TUBE 11	
	= CYAN	= TUBE 12	144 CORE
	= PERAK	= TUBE 14	
	= EMAS	= TUBE 15	
	= BIRU	= TUBE 16	
	= ORANGE	= TUBE 17	
	= HIJAU	= TUBE 18	
	= COKLAT	= TUBE 19	
	= ABU	= TUBE 20	
	= PUTIH	= TUBE 21	
	= MERAH	= TUBE 22	264 CORE

STANDARD WARNA CORE

VISUAL	WARNA	NO. CORE
	= BIRU	= CORE 1
	= ORANGE	= CORE 2
	= HIJAU	= CORE 3
	= COKLAT	= CORE 4
	= ABU	= CORE 5
	= PUTIH	= CORE 6
	= MERAH	= CORE 7
	= HITAM	= CORE 8
	= KUNING	= CORE 9
	= UNGU	= CORE 10
	= PINK	= CORE 11
	= CYAN	= CORE 12

KETERANGAN:

TUBE KABEL
CORE KABEL
JAKET KABEL

ODP/FAT

ALOKASI CORE:
KAPASITAS CORE KABEL
NO. TUBE KABEL
NO. CORE KABEL

FO.00.T0.CO
0 HP
SP.1:8

JUMLAH HOMEPASS ODP
SPLITER ODP

ODP

XXXX00.00.00.00
INHOUSE/VENDOR

LABEL ODP
PEMASANGAN

KAPASITAS KABEL, TUBE DAN CORE

A. 6 CORE / 1 TUBE, 1 TUBE = 6 CORE
B. 12 CORE / 2 TUBE, 1 TUBE = 6 CORE
C. 24 CORE / 4 TUBE, 1 TUBE = 6 CORE
D. 48 CORE / 4 TUBE, 1 TUBE = 12 CORE
F. 96 CORE / 8 TUBE, 1 TUBE = 12 CORE
G. 144 CORE / 12 TUBE, 1 TUBE = 12 CORE
H. 264 CORE / 22 TUBE, 1 TUBE = 12 CORE

AS BUILT DRAWING
OUTSIDE PLAN
FIBER TO THE HOME

PROJECT TYPE

: ...

AS PLAN NUMBER

: 0000.A/APD/KOTA/FTTH/VENDOR/ROUTE PLAN/VIII/17

AS BUILT NUMBER

: 0000.A/ABD/KOTA/FTTH/VENDOR/ROUTE PLAN/VIII/17

DATE

: TANGGAL / BULAN / TAHUN

MAP ID

:

DATE MAP ID

: BULAN / TAHUN

INHOUSE

LEGEND

QUANTITY

HUB OLT

- PON PORT

FIXING SLACK

-

JOIN CLOSURE

-

ODC

- ODC/FDT/FIBER DISTRIBUTION TERMINAL

- PCS - 72 CORE
- PCS - 24 CORE

ODP

- ODP/FAT/FIBER ACCESS TERMINAL

1 PCS 1:8
- PCS 1:8X2

EXISTING MKM HANDHOLE

-

HANDHOLE 150X150X150 CM

-

HANDHOLE 120X120X120 CM

-

HANDHOLE 100X100X100 CM

-

HANDHOLE 80X80X80 CM

-

HANDHOLE PIT 60X60X60 CM

-

HANDHOLE PIT 40X40X40 CM

-

CABLE RISER

-

RILLING ASPHALT (BORING ASPAL)

-

EXCAVATION ASPHALT (GALI ASPAL)

-

EXCAVATION LAND (GALI TANAH)

-

EXCAVATION GRASS (GALI RUMPUT)

-

POLE 9 METER

-

POLE 7 METER

-

GALVANIZED PIPE 6 METER

-

EXISTING MKM POLE

-

ANOTHER POLE

-

L-KONEKTOR

-

T-KONEKTOR

-

DUCT FO.

-

DUCT DW.

-

DROP WIRE

-

FIBER 6/2T

-

FIBER 12/2T

-

FIBER 24/4T

-

FIBER 48/4T

6 M

FIBER 72/6T

-

FIBER 96/8T

-

FIBER 144/12T

-

FIBER 264/22T

-

HOMEPASS

192

HUB AREA

: OLT

NODE AREA

: KARTINI

CITY AREA

: JAKARTA PUSAT

ACKNOWLEDGE

KADIV ROLLOUT

KADIV PPL

REVIEW

Ka, Dept ROLLOUT

Ka, Dept PPL

DRAWING NAME

SCALE

ODP LAYOUT

NTS
PAGE
1 OF 1

PT. MNC KABEL MEDIACOM

REVISION

CHECKED BY

DRAWN BY

INITIALS

DATE

PM. REGION

STANDARD WARNA TUBE

VISUAL	WARNA	NO. TUBE	KAP. KABEL
	= BIRU	= TUBE 1	6 CORE
	= ORANGE	= TUBE 2	12 CORE
	= HIJAU	= TUBE 3	
	= COKLAT	= TUBE 4	24/48 CORE
	= ABU	= TUBE 5	
	= PUTIH	= TUBE 6	
	= MERAH	= TUBE 7	
	= HITAM	= TUBE 8	96 CORE
	= KUNING	= TUBE 9	
	= UNGU	= TUBE 10	
	= PINK	= TUBE 11	
	= CYAN	= TUBE 12	144 CORE
	= PERAK	= TUBE 14	
	= EMAS	= TUBE 15	
	= BIRU	= TUBE 16	
	= ORANGE	= TUBE 17	
	= HIJAU	= TUBE 18	
	= COKLAT	= TUBE 19	
	= ABU	= TUBE 20	
	= PUTIH	= TUBE 21	
	= MERAH	= TUBE 22	264 CORE

STANDARD WARNA CORE

VISUAL	WARNA	NO. CORE
	= BIRU	= CORE 1
	= ORANGE	= CORE 2
	= HIJAU	= CORE 3
	= COKLAT	= CORE 4
	= ABU	= CORE 5
	= PUTIH	= CORE 6
	= MERAH	= CORE 7
	= HITAM	= CORE 8
	= KUNING	= CORE 9
	= UNGU	= CORE 10
	= PINK	= CORE 11
	= CYAN	= CORE 12

KETERANGAN:

TUBE KABEL
CORE KABEL
JAKET KABEL

ODP/FAT

FO.00.T0.C0
0 HP
SP.1:8

ODP

XXXX00.00.00.00
INHOUSE/VENDOR

ALOKASI CORE:

KAPASITAS CORE KABEL
NO. TUBE KABEL
NO. CORE KABEL

JUMLAH HOMEPASS ODP
SPLITER ODP

LABEL ODP
PEMASANGAN

KAPASITAS KABEL, TUBE DAN CORE

A. 6 CORE / 1 TUBE, 1 TUBE = 6 CORE
B. 12 CORE / 2 TUBE, 1 TUBE = 6 CORE
C. 24 CORE / 4 TUBE, 1 TUBE = 6 CORE
D. 48 CORE / 4 TUBE, 1 TUBE = 12 CORE
F. 96 CORE / 8 TUBE, 1 TUBE = 12 CORE
G. 144 CORE / 12 TUBE, 1 TUBE = 12 CORE
H. 264 CORE / 22 TUBE, 1 TUBE = 12 CORE

GRAND KARTINI

ODC24 KTN51.01

AS BUILT DRAWING
OUTSIDE PLAN
FIBER TO THE HOME

PROJECT TYPE : ...

AS PLAN NUMBER : 0000.A/APD/KOTA/FTTH/VENDOR/ROUTE PLAN/VIII/17

AS BUILT NUMBER : 0000.A/ABD/KOTA/FTTH/VENDOR/ROUTE PLAN/VIII/17

DATE : TANGGAL / BULAN / TAHUN

MAP ID :

DATE MAP ID : BULAN / TAHUN

INHOUSE

LEGEND

HUB OLT

- PON PORT

FIXING SLACK

-

JOIN CLOSURE

-

ODC

- ODC/FDT/FIBER DISTRIBUTION TERMINAL

- PCS - 72 CORE
1 PCS - 24 CORE

ODP

- ODP/FAT/FIBER ACCESS TERMINAL

24 PCS 1:8
- PCS 1:8X2

EXISTING MKM HANDHOLE

-

HANDHOLE 150X150X150 CM

-

HANDHOLE 120X120X120 CM

-

HANDHOLE 100X100X100 CM

-

HANDHOLE 80X80X80 CM

-

HANDHOLE PIT 60X60X60 CM

-

HANDHOLE PIT 40X40X40 CM

-

CABLE RISER

-

RILLING ASPHALT (BORING ASPAL)

-

EXCAVATION ASPHALT (GALI ASPAL)

-

EXCAVATION LAND (GALI TANAH)

-

EXCAVATION GRASS (GALI RUMPUT)

-

POLE 9 METER

-

POLE 7 METER

-

GALVANIZED PIPE 6 METER

-

EXISTING MKM POLE

-

ANOTHER POLE

-

L-KONEKTOR

-

T-KONEKTOR

-

DUCT FO.

-

DUCT DW.

-

DROP WIRE

-

FIBER 6/2T

-

FIBER 12/2T

-

FIBER 24/4T

-

FIBER 48/4T

-

FIBER 72/6T

-

FIBER 96/8T

-

FIBER 144/12T

-

FIBER 264/22T

-

HOMEPASS

192

HUB AREA : OLT

NODE AREA : KARTINI

CITY AREA : JAKARTA PUSAT

ACKNOWLEDGE

KADIV ROLLOUT

KADIV PPL

REVIEW

Ka, Dept ROLLOUT

Ka, Dept PPL

DRAWING NAME

SCALE

SPlicing SEQUENCE

NTS

PAGE

1 OF 1

PT. MNC KABEL MEDIACOM

REVISION

CHECKED BY

DRAWN BY

INITIALS

DATE

PM. REGION

MKM_FRAME_REV04E_2017

STANDARD WARNA TUBE

VISUAL	WARNA	NO. TUBE	KAP. KABEL
	= BIRU	= TUBE 1	6 CORE
	= ORANGE	= TUBE 2	12 CORE
	= HIJAU	= TUBE 3	
	= COKLAT	= TUBE 4	24/48 CORE
	= ABU	= TUBE 5	
	= PUTIH	= TUBE 6	
	= MERAH	= TUBE 7	
	= HITAM	= TUBE 8	96 CORE
	= KUNING	= TUBE 9	
	= UNGU	= TUBE 10	
	= PINK	= TUBE 11	
	= CYAN	= TUBE 12	144 CORE
	= PERAK	= TUBE 14	
	= EMAS	= TUBE 15	
	= BIRU	= TUBE 16	
	= ORANGE	= TUBE 17	
	= HIJAU	= TUBE 18	
	= COKLAT	= TUBE 19	
	= ABU	= TUBE 20	
	= PUTIH	= TUBE 21	
	= MERAH	= TUBE 22	264 CORE

STANDARD WARNA CORE

VISUAL	WARNA	NO. CORE
	= BIRU	= CORE 1
	= ORANGE	= CORE 2
	= HIJAU	= CORE 3
	= COKLAT	= CORE 4
	= ABU	= CORE 5
	= PUTIH	= CORE 6
	= MERAH	= CORE 7
	= HITAM	= CORE 8
	= KUNING	= CORE 9
	= UNGU	= CORE 10
	= PINK	= CORE 11
	= CYAN	= CORE 12

KETERANGAN:

TUBE KABEL
CORE KABEL
JAKET KABEL

ODP/FAT

ALOKASI CORE:

KAPASITAS CORE KABEL
NO. TUBE KABEL
NO. CORE KABEL

FO.00.T0.C0
0 HP
SP.1:8

JUMLAH HOMEPASS ODP
SPLITER ODP

ODP

LABEL ODP
PEMASANGAN

KAPASITAS KABEL, TUBE DAN CORE

A. 6 CORE / 1 TUBE, 1 TUBE = 6 CORE
B. 12 CORE / 2 TUBE, 1 TUBE = 6 CORE
C. 24 CORE / 4 TUBE, 1 TUBE = 6 CORE
D. 48 CORE / 4 TUBE, 1 TUBE = 12 CORE
F. 96 CORE / 8 TUBE, 1 TUBE = 12 CORE
G. 144 CORE / 12 TUBE, 1 TUBE = 12 CORE
H. 264 CORE / 22 TUBE, 1 TUBE = 12 CORE

ODMC24.KTN51.01

AS BUILT DRAWING
OUTSIDE PLAN
FIBER TO THE HOME

PROJECT TYPE : ...

AS PLAN NUMBER : 0000.A/APD/KOTA/FTTH/VENDOR/ROUTE PLAN/VIII/17

AS BUILT NUMBER : 0000.A/ABD/KOTA/FTTH/VENDOR/ROUTE PLAN/VIII/17

DATE : TANGGAL / BULAN / TAHUN

MAP ID :

DATE MAP ID : BULAN / TAHUN

INHOUSE

LEGEND

HUB OLT

- PON PORT

FIXING SLACK

-

JOIN CLOSURE

-

ODC

- ODC/FDT/FIBER DISTRIBUTION TERMINAL

- PCS - 72 CORE
1 PCS - 24 CORE

ODP

- ODP/FAT/FIBER ACCESS TERMINAL

- PCS 1:8
- PCS 1:8X2

EXISTING MKM HANDHOLE

-

HANDHOLE 150X150X150 CM

-

HANDHOLE 120X120X120 CM

-

HANDHOLE 100X100X100 CM

-

HANDHOLE 80X80X80 CM

-

HANDHOLE PIT 60X60X60 CM

-

HANDHOLE PIT 40X40X40 CM

-

CABLE RISER

-

RILLING ASPHALT (BORING ASPAL)

-

EXCAVATION ASPHALT (GALI ASPAL)

-

EXCAVATION LAND (GALI TANAH)

-

EXCAVATION GRASS (GALI RUMPUT)

-

POLE 9 METER

-

POLE 7 METER

-

GALVANIZED PIPE 6 METER

-

EXISTING MKM POLE

-

ANOTHER POLE

-

L-KONEKTOR

-

T-KONEKTOR

-

DUCT FO.

-

DUCT DW.

-

DROP WIRE

-

FIBER 6/2T

-

FIBER 12/2T

-

FIBER 24/4T

-

FIBER 48/4T

-

FIBER 72/6T

-

FIBER 96/8T

-

FIBER 144/12T

-

FIBER 264/22T

-

HOMEPASS

192

HUB AREA : OLT

NODE AREA : KARTINI

CITY AREA : JAKARTA PUSAT

ACKNOWLEDGE

KADIV ROLLOUT

KADIV PPL

REVIEW

Ka, Dept ROLLOUT

Ka, Dept PPL

DRAWING NAME

SCALE

ODC LAYOUT

NTS

PAGE

1 OF 1

PT. MNC KABEL MEDIACOM

REVISION

CHECKED BY

DRAWN BY

INITIALS

DATE

PM. REGION

MKM_FRAME_REV04E_2017

