
































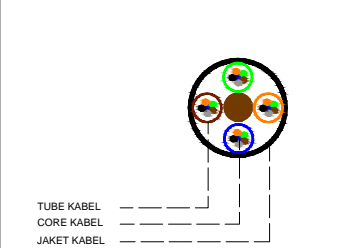


STANDARD WARNA TUBE			
VISUAL	WARNA	NO. TUBE	KAP. KABEL
	= BIRU	= TUBE 1	6 CORE
	= ORANGE	= TUBE 2	12 CORE
	= HIJAU	= TUBE 3	
	= COKLAT	= TUBE 4	24/48 CORE
	= ABU	= TUBE 5	
	= PUTIH	= TUBE 6	
	= MERAH	= TUBE 7	
	= HITAM	= TUBE 8	96 CORE
	= KUNING	= TUBE 9	
	= UNGU	= TUBE 10	
	= PINK	= TUBE 11	
	= CYAN	= TUBE 12	144 CORE
	= PERAK	= TUBE 14	
	= EMAS	= TUBE 15	
	= BIRU	= TUBE 16	
	= ORANGE	= TUBE 17	
	= HIJAU	= TUBE 18	
	= COKLAT	= TUBE 19	
	= ABU	= TUBE 20	
	= PUTIH	= TUBE 21	
	= MERAH	= TUBE 22	264 CORE


STANDARD WARNA CORE		
VISUAL	WARNA	NO. CORE
	= BIRU	= CORE 1
	= ORANGE	= CORE 2
	= HIJAU	= CORE 3
	= COKLAT	= CORE 4
	= ABU	= CORE 5
	= PUTIH	= CORE 6
	= MERAH	= CORE 7
	= HITAM	= CORE 8
	= KUNING	= CORE 9
	= UNGU	= CORE 10
	= PINK	= CORE 11
	= CYAN	= CORE 12


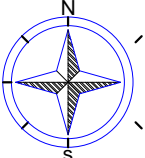
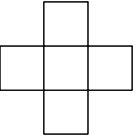






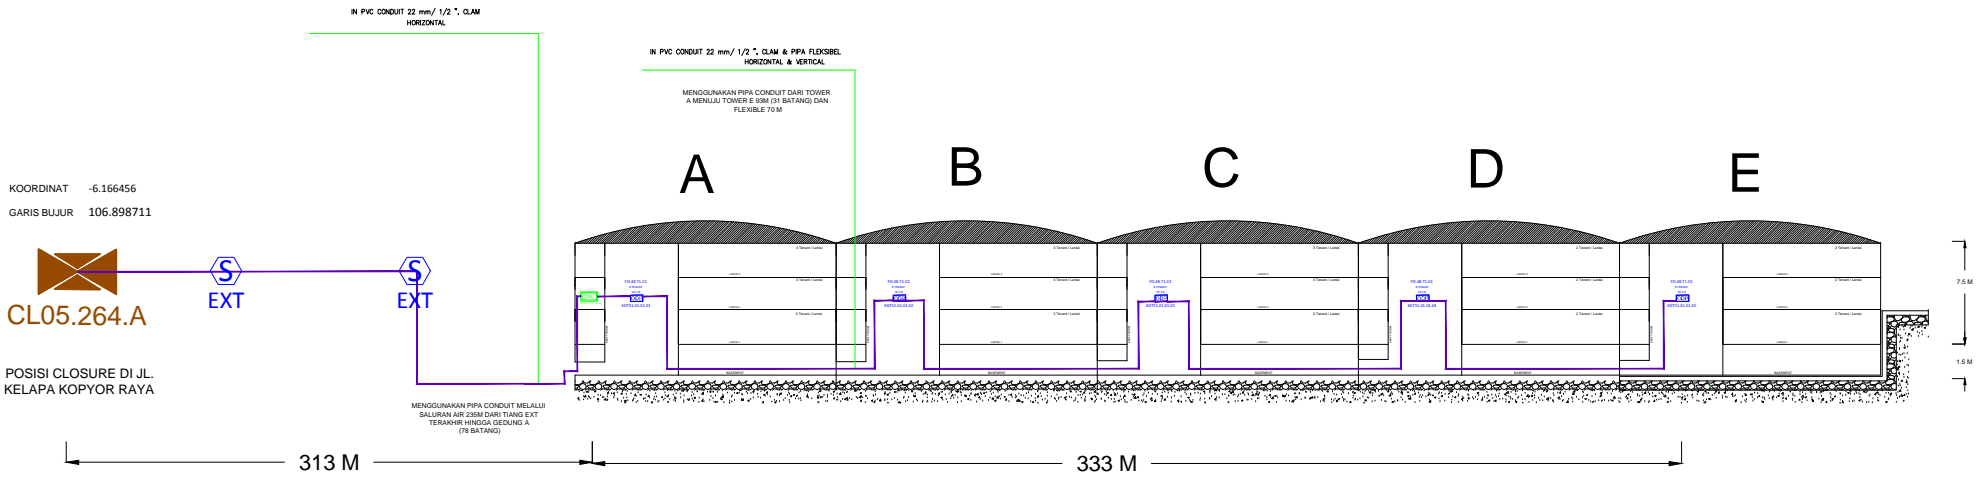


 















KETERANGAN:



KAPASITAS KABEL, TUBE DAN CORE
A. 6 CORE / 1 TUBE, 1 TUBE = 6 CORE
B. 12 CORE / 2 TUBE, 1 TUBE = 6 CORE
C. 24 CORE / 4 TUBE, 1 TUBE = 6 CORE
D. 48 CORE / 4 TUBE, 1 TUBE = 12 CORE
F. 96 CORE / 8 TUBE, 1 TUBE = 12 CORE
G. 144 CORE / 12 TUBE, 1 TUBE = 12 CORE
H. 264 CORE / 22 TUBE, 1 TUBE = 12 CORE

SUMMERVILLE APARTEMEN



AS BUILT DRAWING RETAIL DISTRIBUTION FIBER TO THE BUILDING			
DRAWING NUMBER : DATE :			
			
			
LEGEND		QUANTITY	
	= Optical Line Termination	-	
	= ACCESS POINT	-	
	= DISTRIBUTION SWITCH	-	
	= TELEPHONE EXTENSION IP	-	
	= TELEVISION INTERNET PROTOCOL	-	
	= JOINER	-	
	= MAIN SWITCH	-	
	= OPTICAL DISTRIBUTION CABINET	1 PCS	
	= SET UP BOX	-	
	= FAT / ODP SPLITTER 1:8	5 PCS	
	= FAT / ODP SPLITTER 1:8x2	- PCS	
	= OPTICAL NETWORK TERMINATION	-	
	= OUTLATE DATA	-	
	= TERMINAL BOX	-	
	= FACE PLATE	-	
	= OPTIC TERMINASI BOX	-	
	= CLOSURE	1 EXT	
	= HANDHOLE	-	
	= POLE 9 METER	-	
	= POLE 7 METER	2 EXT	
	= DROP WIRE	-	
	= UTP CABLE RJ11	-	
	= FIBER 48C/4T	645 M	
	= FIBER 96C/8T	-	
	= FIBER 264C/22T	-	
JUMLAH HOMEPASS		41	
HUB AREA : -			
NODE AREA : KELAPA GADING TIMUR RW.15			
REGION AREA : JAKARTA UTARA			
CITY AREA : JAKARTA			
ASCERTAIN :			
PT. MNC KABEL MEDIAKOM		PT. MNC KABEL MEDIAKOM	
FAJAR DEWANTO		MOCH. SOFYAN PRIAMBODO	
PT. MNC KABEL MEDIAKOM		PT. MNC KABEL MEDIAKOM	
MUHAMMAD AMIR			
DRAWING NAME		SCALE	
APARTEMEN SUMMERVILLE		NTS	1 OF 4
		A3	
PT. MNC KABEL MEDIAKOM			
REVISION	NAME	DATE	SIGNATURE / CP
APPROVED BY	AMIR	-	
CHECKED BY	PALTIRAJA	-	
DRAWN BY	PALTIRAJA	-	
NO ARSIP FILE :			--