

STANDARD WARNA TUBE

VISUAL	WARNA	NO. TUBE	KAP. KABEL
	= BIRU	= TUBE 1	6 CORE
	= ORANGE	= TUBE 2	12 CORE
	= HIJAU	= TUBE 3	
	= COKLAT	= TUBE 4	24/48 CORE
	= ABU	= TUBE 5	
	= PUTIH	= TUBE 6	
	= MERAH	= TUBE 7	
	= HITAM	= TUBE 8	96 CORE
	= KUNING	= TUBE 9	
	= UNGU	= TUBE 10	
	= PINK	= TUBE 11	
	= CYAN	= TUBE 12	144 CORE
	= PERAK	= TUBE 14	
	= EMAS	= TUBE 15	
	= BIRU	= TUBE 16	
	= ORANGE	= TUBE 17	
	= HIJAU	= TUBE 18	
	= COKLAT	= TUBE 19	
	= ABU	= TUBE 20	
	= PUTIH	= TUBE 21	
	= MERAH	= TUBE 22	264 CORE

STANDARD WARNA CORE

VISUAL	WARNA	NO. CORE
	= BIRU	= CORE 1
	= ORANGE	= CORE 2
	= HIJAU	= CORE 3
	= COKLAT	= CORE 4
	= ABU	= CORE 5
	= PUTIH	= CORE 6
	= MERAH	= CORE 7
	= HITAM	= CORE 8
	= KUNING	= CORE 9
	= UNGU	= CORE 10
	= PINK	= CORE 11
	= CYAN	= CORE 12

KETERANGAN:

TUBE KABEL  
CORE KABEL  
JAKET KABEL

ODP/FAT

ALOKASI CORE:

KAPASITAS CORE KABEL

NO. TUBE KABEL

NO. CORE KABEL

FO.00.T0.C0

0 HP

SP.1:8

ODP

XXXX00.00.00.00

INHOUSE/VENDOR

JUMLAH HOMEPASS ODP

SPLITER ODP

LABEL ODP

PEMASANGAN

KAPASITAS KABEL, TUBE DAN CORE

A. 6 CORE / 1 TUBE, 1 TUBE = 6 CORE

B. 12 CORE / 2 TUBE, 1 TUBE = 6 CORE

C. 24 CORE / 4 TUBE, 1 TUBE = 6 CORE

D. 48 CORE / 4 TUBE, 1 TUBE = 12 CORE

F. 96 CORE / 8 TUBE, 1 TUBE = 12 CORE

G. 144 CORE / 12 TUBE, 1 TUBE = 12 CORE

H. 264 CORE / 22 TUBE, 1 TUBE = 12 CORE

APARTEMEN DELTA CAKUNG

CA      CB      DA      DB

MKM\_FRAME\_REV04E\_2017

AS BUILT DRAWING  
OUTSIDE PLAN  
FIBER TO THE HOME

PROJECT TYPE

:

...

AS PLAN NUMBER

:

0000.A/APD/KOTA/FTTH/VENDOR/ROUTE PLAN/VIII/17

AS BUILT NUMBER

:

0000.A/ABD/KOTA/FTTH/VENDOR/ROUTE PLAN/VIII/17

DATE

:

TANGGAL / BULAN / TAHUN

MAP ID

:

.....

DATE MAP ID

:

BULAN / TAHUN

INHOUSE

LEGEND

QUANTITY

HUB OLT

1 PON PORT

FIXING SLACK

-

JOIN CLOSURE

1 EXT

ODC/FDT/FIBER DISTRIBUTION TERMINAL

1 PCS - 72 CORE  
- PCS - 24 CORE

ODP/FAT/FIBER ACCESS TERMINAL

24 PCS 1:8  
- PCS 1:8X2

EXISTING MKM HANDHOLE

-

HANDHOLE 150X150X150 CM

-

HANDHOLE 120X120X120 CM

-

HANDHOLE 100X100X100 CM

-

HANDHOLE 80X80X80 CM

-

HANDHOLE PIT 60X60X60 CM

-

HANDHOLE PIT 40X40X40 CM

-

CABLE RISER

-

RILLING ASPHALT (BORING ASPAL)

-

EXCAVATION ASPHALT (GALI ASPAL)

-

EXCAVATION LAND (GALI TANAH)

-

EXCAVATION GRASS (GALI RUMPUT)

-

POLE 9 METER

-

POLE 7 METER

10

GALVANIZED PIPE 6 METER

-

EXISTING MKM POLE

16

ANOTHER POLE

-

L-KONEKTOR

-

T-KONEKTOR

-

DUCT FO.

-

DUCT DW.

-

DROP WIRE

-

FIBER 6/2T

-

FIBER 12/2T

-

FIBER 24/4T

-

FIBER 48/4T

1480M

FIBER 72/6T

-

FIBER 96/8T

-

FIBER 144/12T

-

FIBER 264/22T

-

HOMEPASS

192

HUB AREA

:

OLT

NODE AREA

:

PENGGILINGAN

CITY AREA

:

JAKARTA TIMUR

ACKNOWLEDGE

RollOut Division Head

PPL Division Head

CA/Sales Division

IKR Division

REVIEW

OSP Plan Div. Head

OSP Plan Dept. Head

DRAWING NAME

SCALE

DELTA CAKUNG

NTS

PAGE

1 OF 4

PT. MNC KABEL MEDIACOM

REVISION

CHECKED BY

DRAWN BY

INITIALS

DATE

PM. REGION

STANDARD WARNA TUBE

VISUAL	WARNA	NO. TUBE	KAP. KABEL
	= BIRU	= TUBE 1	6 CORE
	= ORANGE	= TUBE 2	12 CORE
	= HIJAU	= TUBE 3	
	= COKLAT	= TUBE 4	24/48 CORE
	= ABU	= TUBE 5	
	= PUTIH	= TUBE 6	
	= MERAH	= TUBE 7	
	= HITAM	= TUBE 8	96 CORE
	= KUNING	= TUBE 9	
	= UNGU	= TUBE 10	
	= PINK	= TUBE 11	
	= CYAN	= TUBE 12	144 CORE
	= PERAK	= TUBE 14	
	= EMAS	= TUBE 15	
	= BIRU	= TUBE 16	
	= ORANGE	= TUBE 17	
	= HIJAU	= TUBE 18	
	= COKLAT	= TUBE 19	
	= ABU	= TUBE 20	
	= PUTIH	= TUBE 21	
	= MERAH	= TUBE 22	264 CORE

STANDARD WARNA CORE

VISUAL	WARNA	NO. CORE
	= BIRU	= CORE 1
	= ORANGE	= CORE 2
	= HIJAU	= CORE 3
	= COKLAT	= CORE 4
	= ABU	= CORE 5
	= PUTIH	= CORE 6
	= MERAH	= CORE 7
	= HITAM	= CORE 8
	= KUNING	= CORE 9
	= UNGU	= CORE 10
	= PINK	= CORE 11
	= CYAN	= CORE 12

KETERANGAN:

TUBE KABEL  
CORE KABEL  
JAKET KABEL

ODP/FAT


ALOKASI CORE:  
KAPASITAS CORE KABEL  
NO. TUBE KABEL  
NO. CORE KABEL

JUMLAH HOMEPASS ODP  
SPLITER ODP

LABEL ODP  
PEMASANGAN

KAPASITAS KABEL, TUBE DAN CORE

A. 6 CORE / 1 TUBE, 1 TUBE = 6 CORE  
B. 12 CORE / 2 TUBE, 1 TUBE = 6 CORE  
C. 24 CORE / 4 TUBE, 1 TUBE = 6 CORE  
D. 48 CORE / 4 TUBE, 1 TUBE = 12 CORE  
F. 96 CORE / 8 TUBE, 1 TUBE = 12 CORE  
G. 144 CORE / 12 TUBE, 1 TUBE = 12 CORE  
H. 264 CORE / 22 TUBE, 1 TUBE = 12 CORE

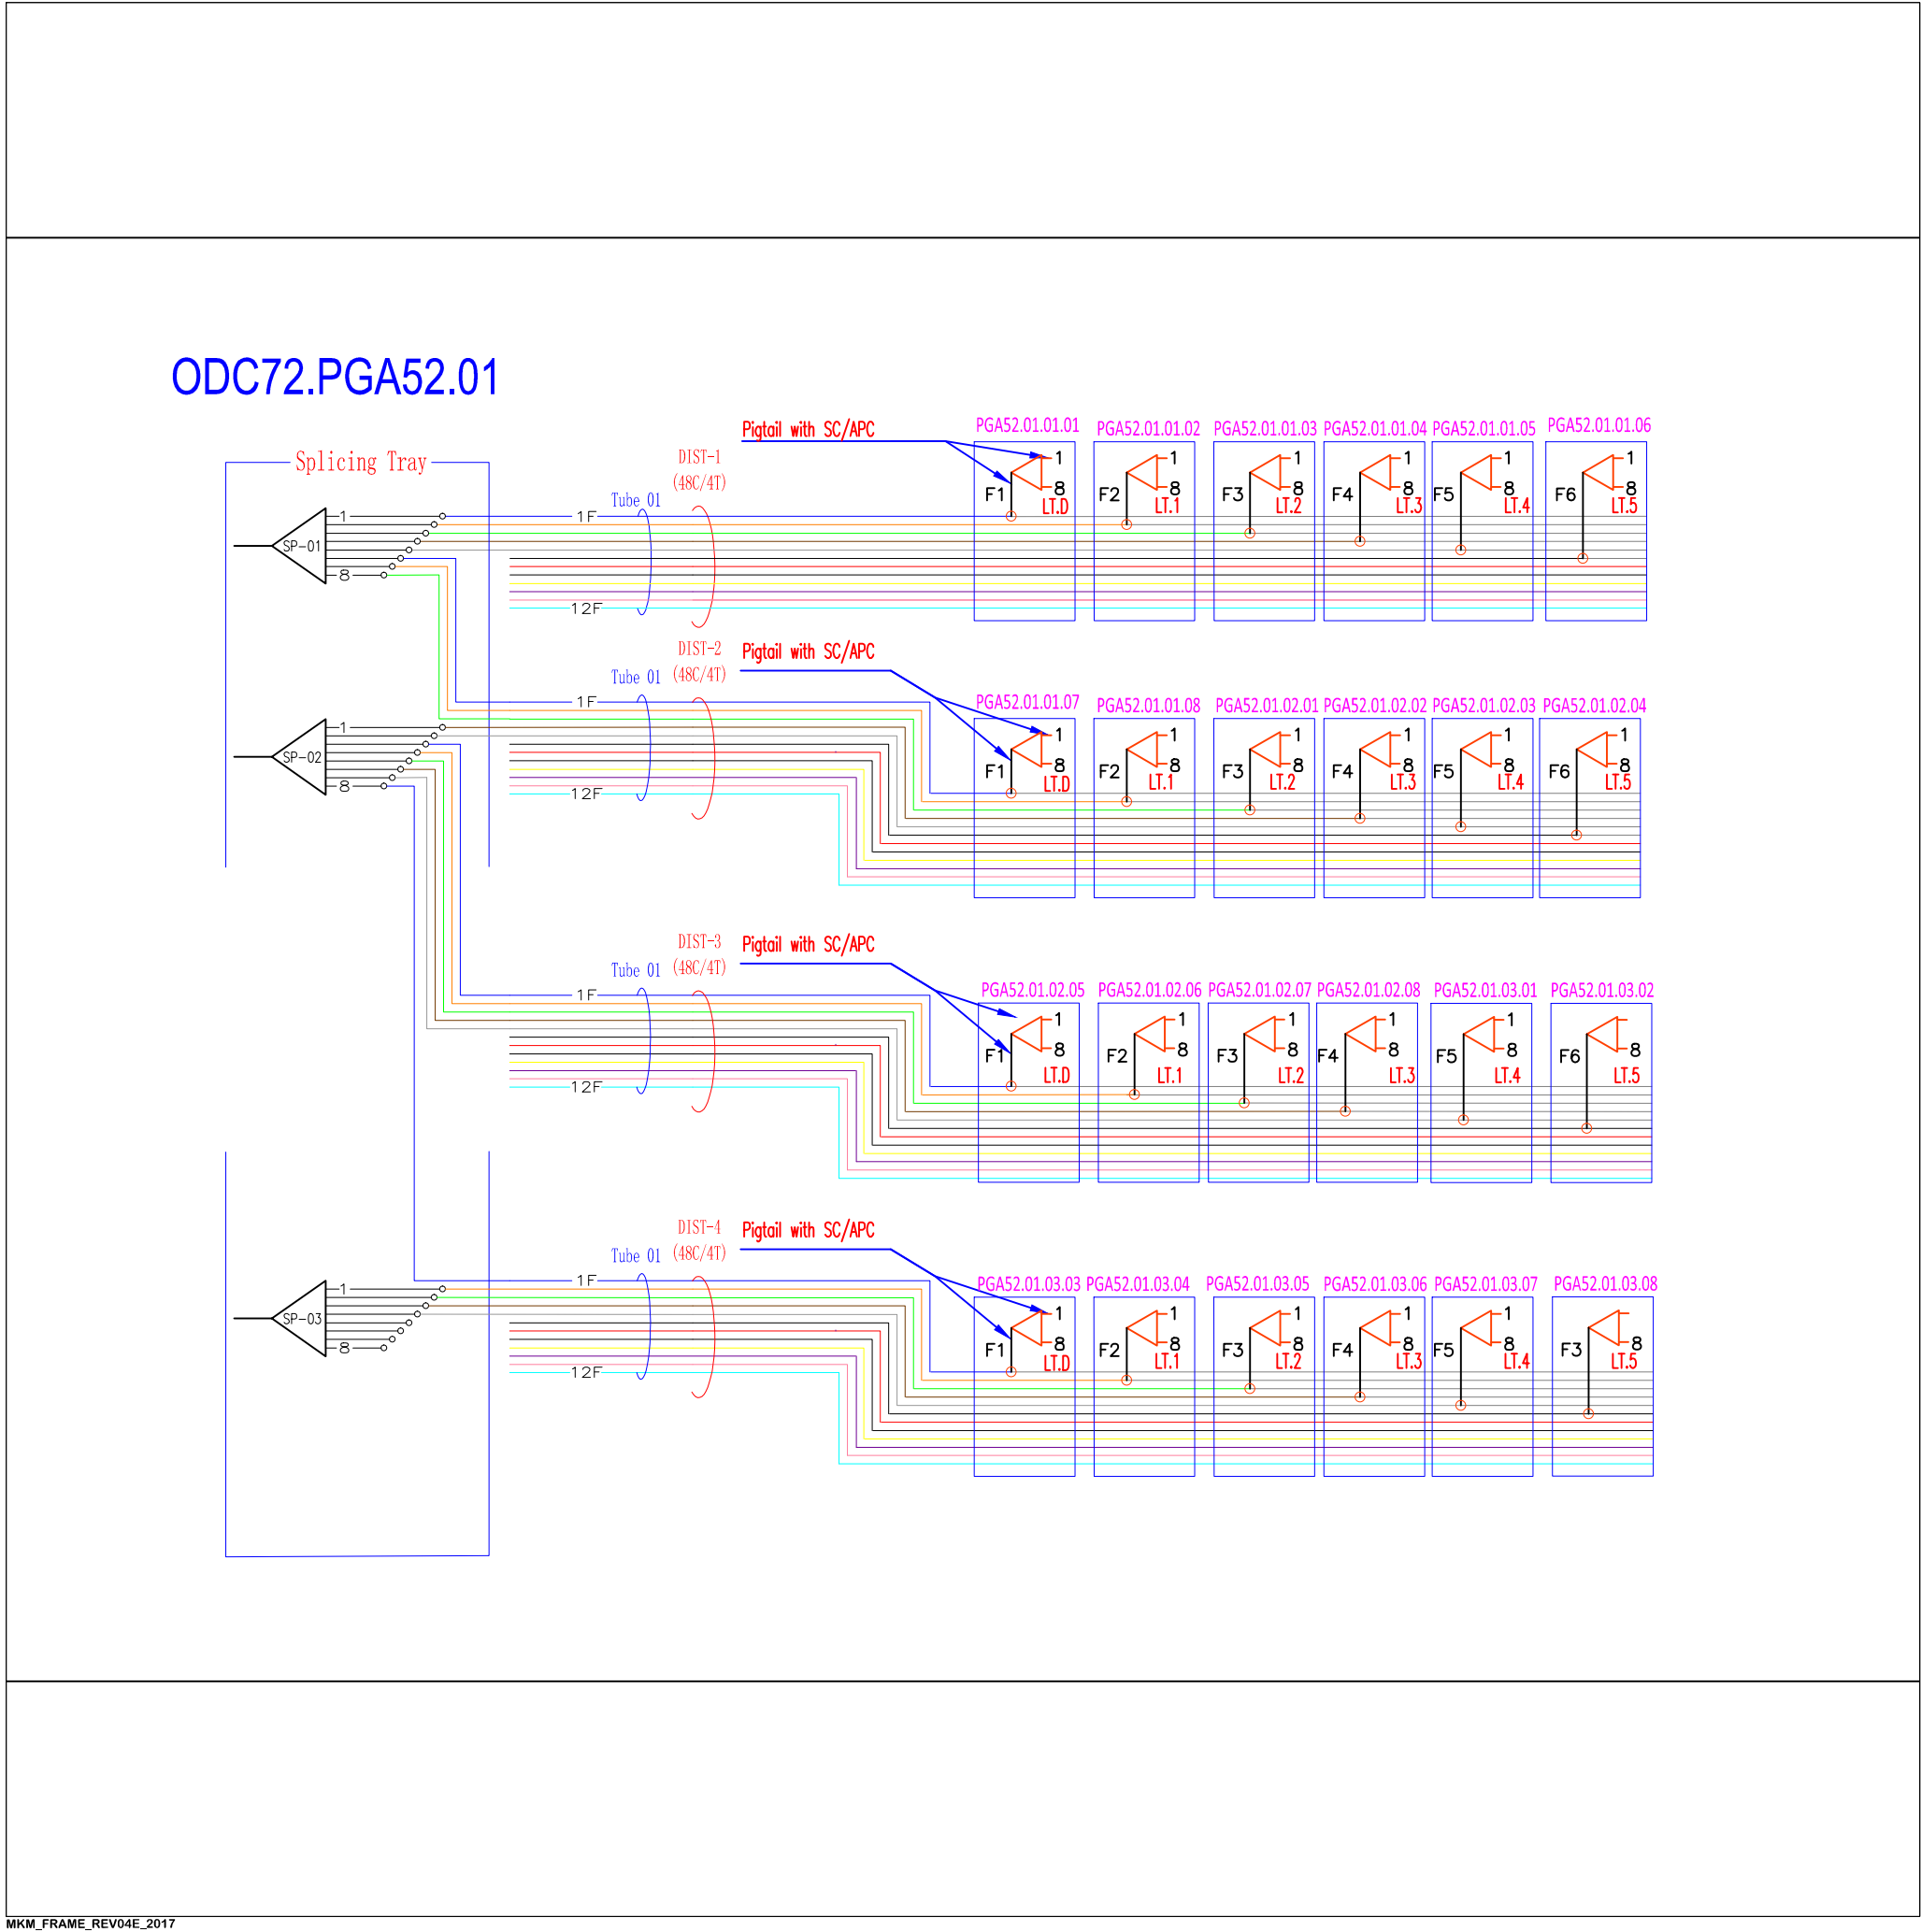

AS BUILT DRAWING  
OUTSIDE PLAN  
FIBER TO THE HOME

PROJECT TYPE

AS PLAN NUMBER

AS BUILT NUMBER

DATE

MAP ID

DATE MAP ID

INHOUSE

LEGEND

QUANTITY

	HUB OLT	- PON PORT
	FIXING SLACK	-
	JOIN CLOSURE	-
	ODC/FDT/FIBER DISTRIBUTION TERMINAL	-1 PCS - 72 CORE - PCS - 24 CORE
	ODP/FAT/FIBER ACCESS TERMINAL	24 PCS 1:8 - PCS 1:8X2
	EXISTING MKM HANDHOLE	-
	HANDHOLE 150X150X150 CM	-
	HANDHOLE 120X120X120 CM	-
	HANDHOLE 100X100X100 CM	-
	HANDHOLE 80X80X80 CM	-
	HANDHOLE PIT 60X60X60 CM	-
	HANDHOLE PIT 40X40X40 CM	-
	CABLE RISER	-
	RILLING ASPHALT (BORING ASPAL)	-
	EXCAVATION ASPHALT (GALI ASPAL)	-
	EXCAVATION LAND (GALI TANAH)	-
	EXCAVATION GRASS (GALI RUMPUT)	-
	POLE 9 METER	-
	POLE 7 METER	-
	GALVANIZED PIPE 6 METER	-
	EXISTING MKM POLE	-
	ANOTHER POLE	-
	L-KONEKTOR	-
	T-KONEKTOR	-
	DUCT FO.	-
	DUCT DW.	-
	DROP WIRE	-
	FIBER 6/2T	-
	FIBER 12/2T	-
	FIBER 24/4T	-
	FIBER 48/4T	-
	FIBER 72/6T	-
	FIBER 96/8T	-
	FIBER 144/12T	-
	FIBER 264/22T	-

HOMEPASS

192

HUB AREA

OLT

NODE AREA

PENGGLILANGAN

CITY AREA

JAKARTA SELATAN

ACKNOWLEDGE

RollOut Division Head

PPL Division Head

CA/Sales Division

IKR Division

REVIEW

OSP Plan Div. Head

OSP Plan Dept. Head

DRAWING NAME

SCALE

DELTA CAKUNG

NTS  
PAGE  
2 OF 4

PT. MNC KABEL MEDIACOM

REVISION

CHECKED BY

DRAWN BY

INITIALS

DATE

PM REGION

STANDARD WARNA TUBE

VISUAL	WARNA	NO. TUBE	KAP. KABEL
	= BIRU	= TUBE 1	6 CORE
	= ORANGE	= TUBE 2	12 CORE
	= HIJAU	= TUBE 3	
	= COKLAT	= TUBE 4	24/48 CORE
	= ABU	= TUBE 5	
	= PUTIH	= TUBE 6	
	= MERAH	= TUBE 7	
	= HITAM	= TUBE 8	96 CORE
	= KUNING	= TUBE 9	
	= UNGU	= TUBE 10	
	= PINK	= TUBE 11	
	= CYAN	= TUBE 12	144 CORE
	= PERAK	= TUBE 14	
	= EMAS	= TUBE 15	
	= BIRU	= TUBE 16	
	= ORANGE	= TUBE 17	
	= HIJAU	= TUBE 18	
	= COKLAT	= TUBE 19	
	= ABU	= TUBE 20	
	= PUTIH	= TUBE 21	
	= MERAH	= TUBE 22	264 CORE

STANDARD WARNA CORE

VISUAL	WARNA	NO. CORE
	= BIRU	= CORE 1
	= ORANGE	= CORE 2
	= HIJAU	= CORE 3
	= COKLAT	= CORE 4
	= ABU	= CORE 5
	= PUTIH	= CORE 6
	= MERAH	= CORE 7
	= HITAM	= CORE 8
	= KUNING	= CORE 9
	= UNGU	= CORE 10
	= PINK	= CORE 11
	= CYAN	= CORE 12

KETERANGAN:

ODP/FAT

ALOKASI CORE:

KAPASITAS CORE KABEL

NO. TUBE KABEL

NO. CORE KABEL

FO.00.T0.C0

0 HP

SP.1:8

ODP

XXXX00.00.00.00

INHOUSE/VENDOR

JUMLAH HOMEPASS ODP

SPLITER ODP

LABEL ODP

PEMASANGAN

KAPASITAS KABEL, TUBE DAN CORE

A. 6 CORE / 1 TUBE, 1 TUBE = 6 CORE

B. 12 CORE / 2 TUBE, 1 TUBE = 6 CORE

C. 24 CORE / 4 TUBE, 1 TUBE = 6 CORE

D. 48 CORE / 4 TUBE, 1 TUBE = 12 CORE

F. 96 CORE / 8 TUBE, 1 TUBE = 12 CORE

G. 144 CORE / 12 TUBE, 1 TUBE = 12 CORE

H. 264 CORE / 22 TUBE, 1 TUBE = 12 CORE

AS BUILT DRAWING  
OUTSIDE PLAN  
FIBER TO THE HOME

PROJECT TYPE

:

...

AS PLAN NUMBER

:

0000.A/APD/KOTA/FTTH/VENDOR/ROUTE PLAN/VIII/17

AS BUILT NUMBER

:

0000.A/ABD/KOTA/FTTH/VENDOR/ROUTE PLAN/VIII/17

DATE

:

TANGGAL / BULAN / TAHUN

MAP ID

:

.....

DATE MAP ID

:

BULAN / TAHUN

INHOUSE

LEGEND

QUANTITY

HUB OLT

- PON PORT

FIXING SLACK

-

JOIN CLOSURE

-

ODC/FDT/FIBER DISTRIBUTION TERMINAL

- PCS - 72 CORE  
- PCS - 24 CORE

ODP/FAT/FIBER ACCESS TERMINAL

- 1 PCS 1:8  
- PCS 1:8X2

EXISTING MKM HANDHOLE

-

HANDHOLE 150X150X150 CM

-

HANDHOLE 120X120X120 CM

-

HANDHOLE 100X100X100 CM

-

HANDHOLE 80X80X80 CM

-

HANDHOLE PIT 60X60X60 CM

-

HANDHOLE PIT 40X40X40 CM

-

CABLE RISER

-

RILLING ASPHALT (BORING ASPAL)

-

EXCAVATION ASPHALT (GALI ASPAL)

-

EXCAVATION LAND (GALI TANAH)

-

EXCAVATION GRASS (GALI RUMPUT)

-

POLE 9 METER

-

POLE 7 METER

-

GALVANIZED PIPE 6 METER

-

EXISTING MKM POLE

-

ANOTHER POLE

-

L-KONEKTOR

-

T-KONEKTOR

-

DUCT FO.

-

DUCT DW.

-

DROP WIRE

-

FIBER 6/2T

-

FIBER 12/2T

-

FIBER 24/4T

-

FIBER 48/4T

6

FIBER 72/6T

-

FIBER 96/8T

-

FIBER 144/12T

-

FIBER 264/22T

-

HOMEPASS

192

HUB AREA

:

OLT

NODE AREA

:

PENGGILINGAN

CITY AREA

:

JAKARTA SELATAN

ACKNOWLEDGE

RollOut Division Head

PPL Division Head

CA/Sales Division

IKR Division

REVIEW

OSP Plan Div. Head

OSP Plan Dept. Head

DRAWING NAME

SCALE

DELTA CAKUNG

NTS

PAGE

3 OF 4

PT. MNC KABEL MEDIACOM

REVISION

INITIALS

DATE

CHECKED BY

PIC PLAN REGION

DRAWN BY

DRAFTER

PM. REGION

2 M

RUANG  
SHAFT

1.5 M

1.5 M

1 M

5 M

STANDARD WARNA TUBE

VISUAL	WARNA	NO. TUBE	KAP. KABEL
<span style="color:blue">—</span>	= BIRU	= TUBE 1	6 CORE
<span style="color:orange">—</span>	= ORANGE	= TUBE 2	12 CORE
<span style="color:green">—</span>	= HIJAU	= TUBE 3	
<span style="color:brown">—</span>	= COKLAT	= TUBE 4	24/48 CORE
<span style="color:gray">—</span>	= ABU	= TUBE 5	
<span style="color:black">—</span>	= PUTIH	= TUBE 6	
<span style="color:red">—</span>	= MERAH	= TUBE 7	
<span style="color:black">—</span>	= HITAM	= TUBE 8	96 CORE
<span style="color:yellow">—</span>	= KUNING	= TUBE 9	
<span style="color:purple">—</span>	= UNGU	= TUBE 10	
<span style="color:pink">—</span>	= PINK	= TUBE 11	
<span style="color:cyan">—</span>	= CYAN	= TUBE 12	144 CORE
<span style="color:gray">—</span>	= PERAK	= TUBE 14	
<span style="color:orange">—</span>	= EMAS	= TUBE 15	
<span style="color:blue">—</span>	= BIRU	= TUBE 16	
<span style="color:orange">—</span>	= ORANGE	= TUBE 17	
<span style="color:green">—</span>	= HIJAU	= TUBE 18	
<span style="color:brown">—</span>	= COKLAT	= TUBE 19	
<span style="color:gray">—</span>	= ABU	= TUBE 20	
<span style="color:black">—</span>	= PUTIH	= TUBE 21	
<span style="color:red">—</span>	= MERAH	= TUBE 22	264 CORE

STANDARD WARNA CORE

VISUAL	WARNA	NO. CORE
<span style="color:blue">—</span>	= BIRU	= CORE 1
<span style="color:orange">—</span>	= ORANGE	= CORE 2
<span style="color:green">—</span>	= HIJAU	= CORE 3
<span style="color:brown">—</span>	= COKLAT	= CORE 4
<span style="color:gray">—</span>	= ABU	= CORE 5
<span style="color:black">—</span>	= PUTIH	= CORE 6
<span style="color:red">—</span>	= MERAH	= CORE 7
<span style="color:black">—</span>	= HITAM	= CORE 8
<span style="color:yellow">—</span>	= KUNING	= CORE 9
<span style="color:purple">—</span>	= UNGU	= CORE 10
<span style="color:pink">—</span>	= PINK	= CORE 11
<span style="color:cyan">—</span>	= CYAN	= CORE 12

KETERANGAN:

TUBE KABEL

CORE KABEL

JAKET KABEL

ODP/FAT

FO.00 TO CO

0 HP

SP 1:8

ODP

XXXXXX.00.00.00

INHOUSE/VENDOR

ALOKASI CORE:

KAPASITAS CORE KABEL

NO. TUBE KABEL

NO. CORE KABEL

JUMLAH HOMEPASS ODP

SPLITER ODP

LABEL ODP

PEMASANGAN

KAPASITAS KABEL, TUBE DAN CORE

A. 6 CORE / 1 TUBE, 1 TUBE = 6 CORE

B. 12 CORE / 2 TUBE, 1 TUBE = 6 CORE

C. 24 CORE / 4 TUBE, 1 TUBE = 6 CORE


D. 48 CORE / 4 TUBE, 1 TUBE = 12 CORE

F. 96 CORE / 8 TUBE, 1 TUBE = 12 CORE

G. 144 CORE / 12 TUBE, 1 TUBE = 12 CORE

H. 264 CORE / 22 TUBE, 1 TUBE = 12 CORE

# ODC72 APARTEMEN DELTA CAKUNG

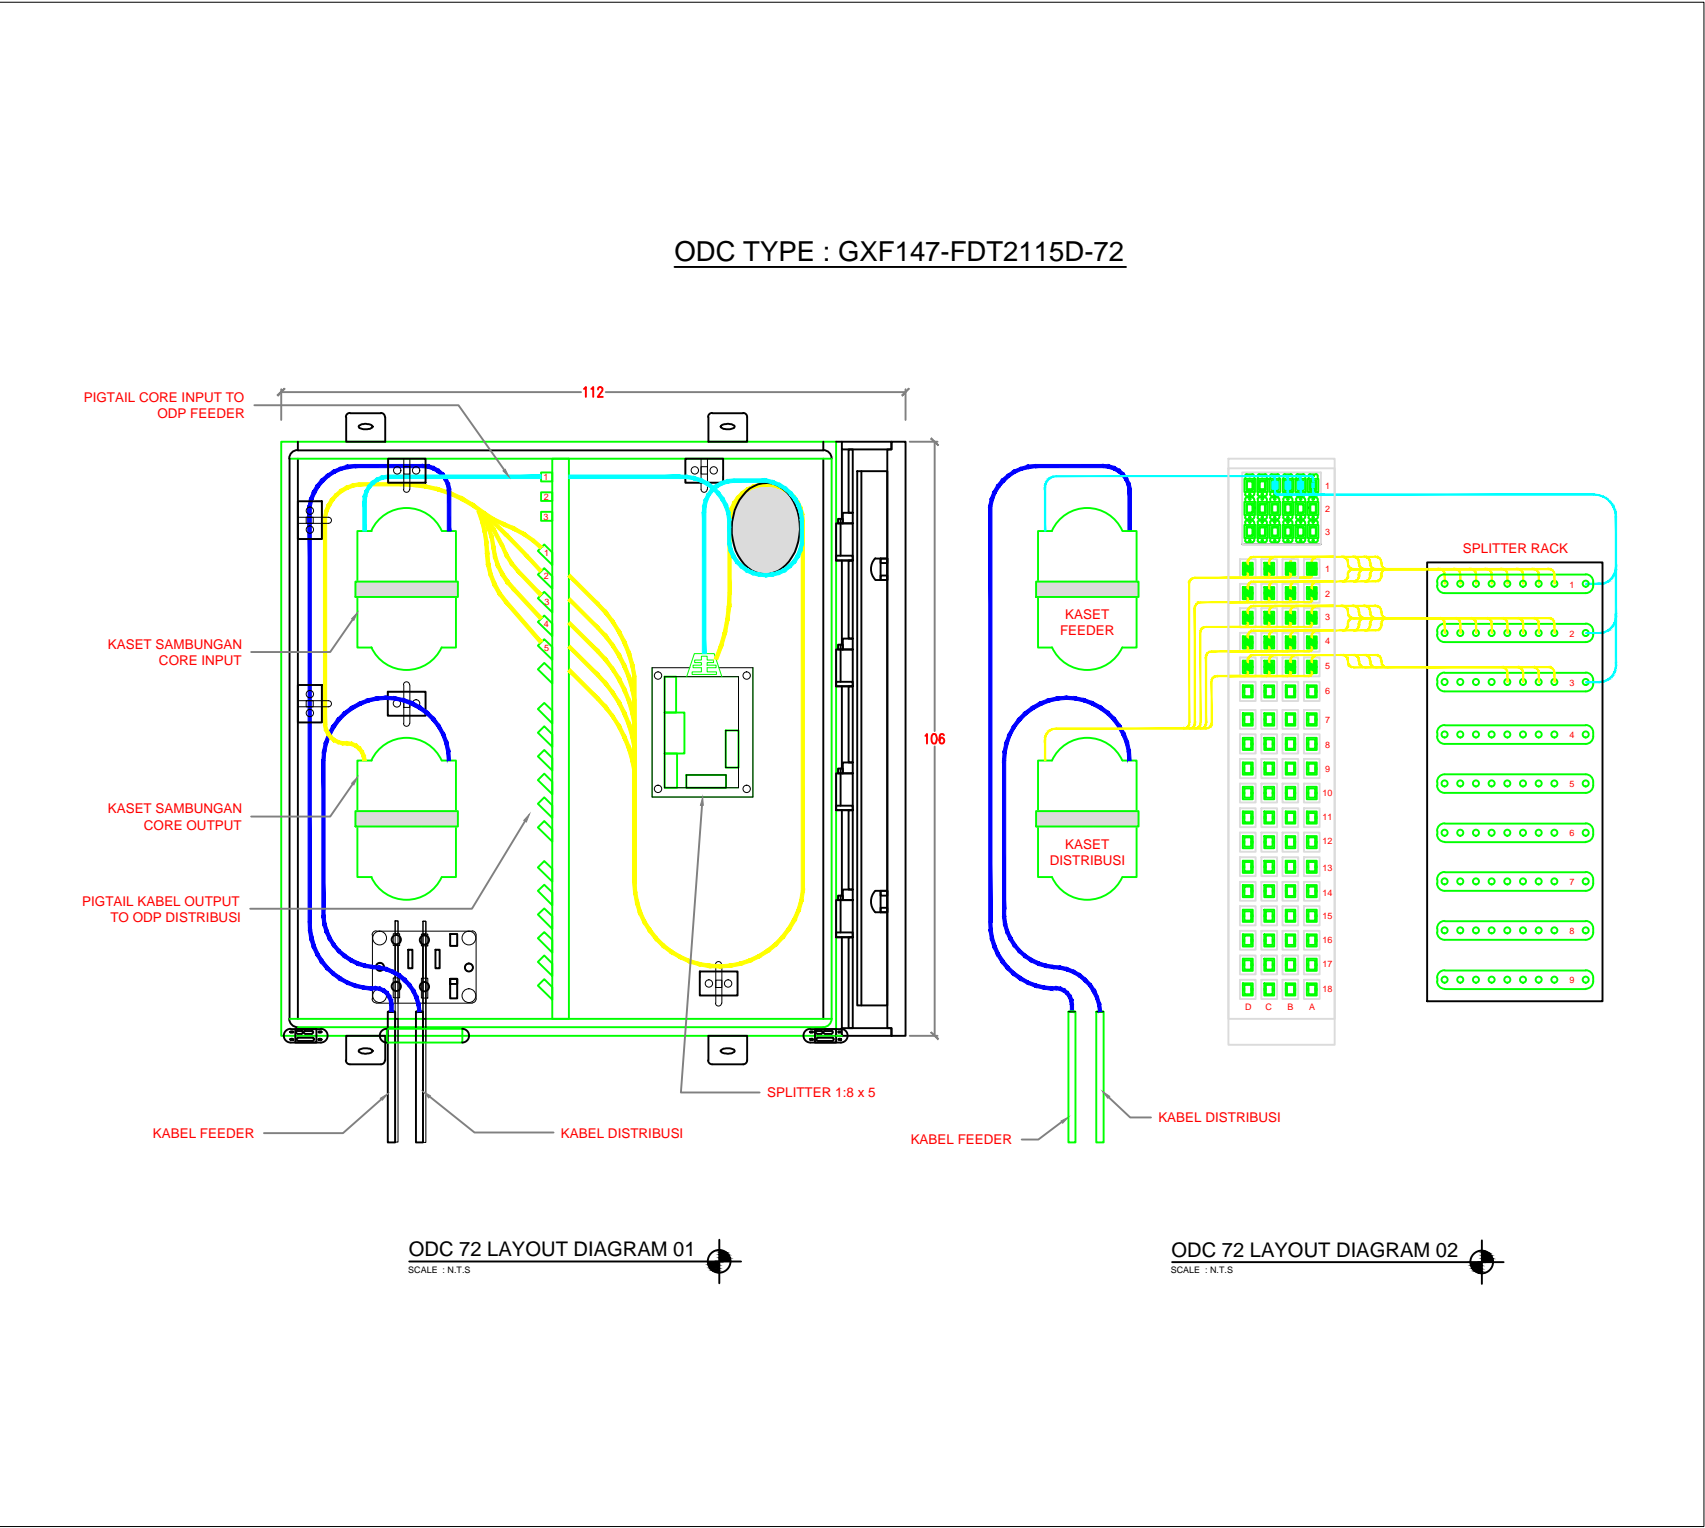

AS BUILT DRAWING  
OUTSIDE PLAN  
FIBER TO THE HOME

PROJECT TYPE : ...

AS PLAN NUMBER : .....

AS BUILT NUMBER : ...

DATE : TANGGAL / BULAN / TAHUN

MAP ID : .....

DATE MAP ID : BULAN / TAHUN

INHOUSE

LEGEND

• HUB OLT

- PON PORT

• FIXING SLACK

-

• JOIN CLOSURE

-

• ODC/FDT/FIBER DISTRIBUTION TERMINAL

- 1 PCS - 72 CORE  
- PCS - 24 CORE

• ODP/FAT/FIBER ACCESS TERMINAL

- PCS 1:8  
- PCS 1:8X2

• EXISTING MKM HANDHOLE

-

• HANDHOLE 150X150X150 CM

-

• HANDHOLE 120X120X120 CM

-

• HANDHOLE 100X100X100 CM

-

• HANDHOLE 80X80X80 CM

-

• HANDHOLE PIT 60X60X60 CM

-

• HANDHOLE PIT 40X40X40 CM

-

• CABLE RISER

-

• RILLING ASPHALT (BORING ASPAL)

-

• EXCAVATION ASPHALT (GALI ASPAL)

-

• EXCAVATION LAND (GALI TANAH)

-

• EXCAVATION GRASS (GALI RUMPUT)

-

• POLE 9 METER

-

• POLE 7 METER

-

• GALVANIZED PIPE 6 METER

-

• EXISTING MKM POLE

-

• ANOTHER POLE

-

• L-KONEKTOR

-

• T-KONEKTOR

-

• DUCT FO.

-

• DUCT DW.

-

• DROP WIRE

-

• FIBER 6/2T

-

• FIBER 12/2T

-

• FIBER 24/4T

-

• FIBER 48/4T

-

• FIBER 72/6T

-

• FIBER 96/8T

-

• FIBER 144/12T

-

• FIBER 264/22T

-

HOMEPASS

192

HUB AREA : OLT

NODE AREA : PENGGILINGAN

CITY AREA : JAKARTA TIMUR

ACKNOWLEDGE

RollOut Division Head

PPL Division Head

CA/Sales Division

IKR Division

REVIEW

OSP Plan Div. Head

OSP Plan Dept. Head

DRAWING NAME

DELTA CAKUNG

SCALE

NTS

PAGE

4 OF 4

PT. MNC KABEL MEDIACOM

REVISION

CHECKED BY

DRAWN BY

INITIALS

PIC PLAN REGION

DRAFTER

DATE

PM. REGION

MKM\_FRAME\_REV04E\_2017